


FOUNDATION PLAN
 1/4" = 1'-0"
 AS-BUILT

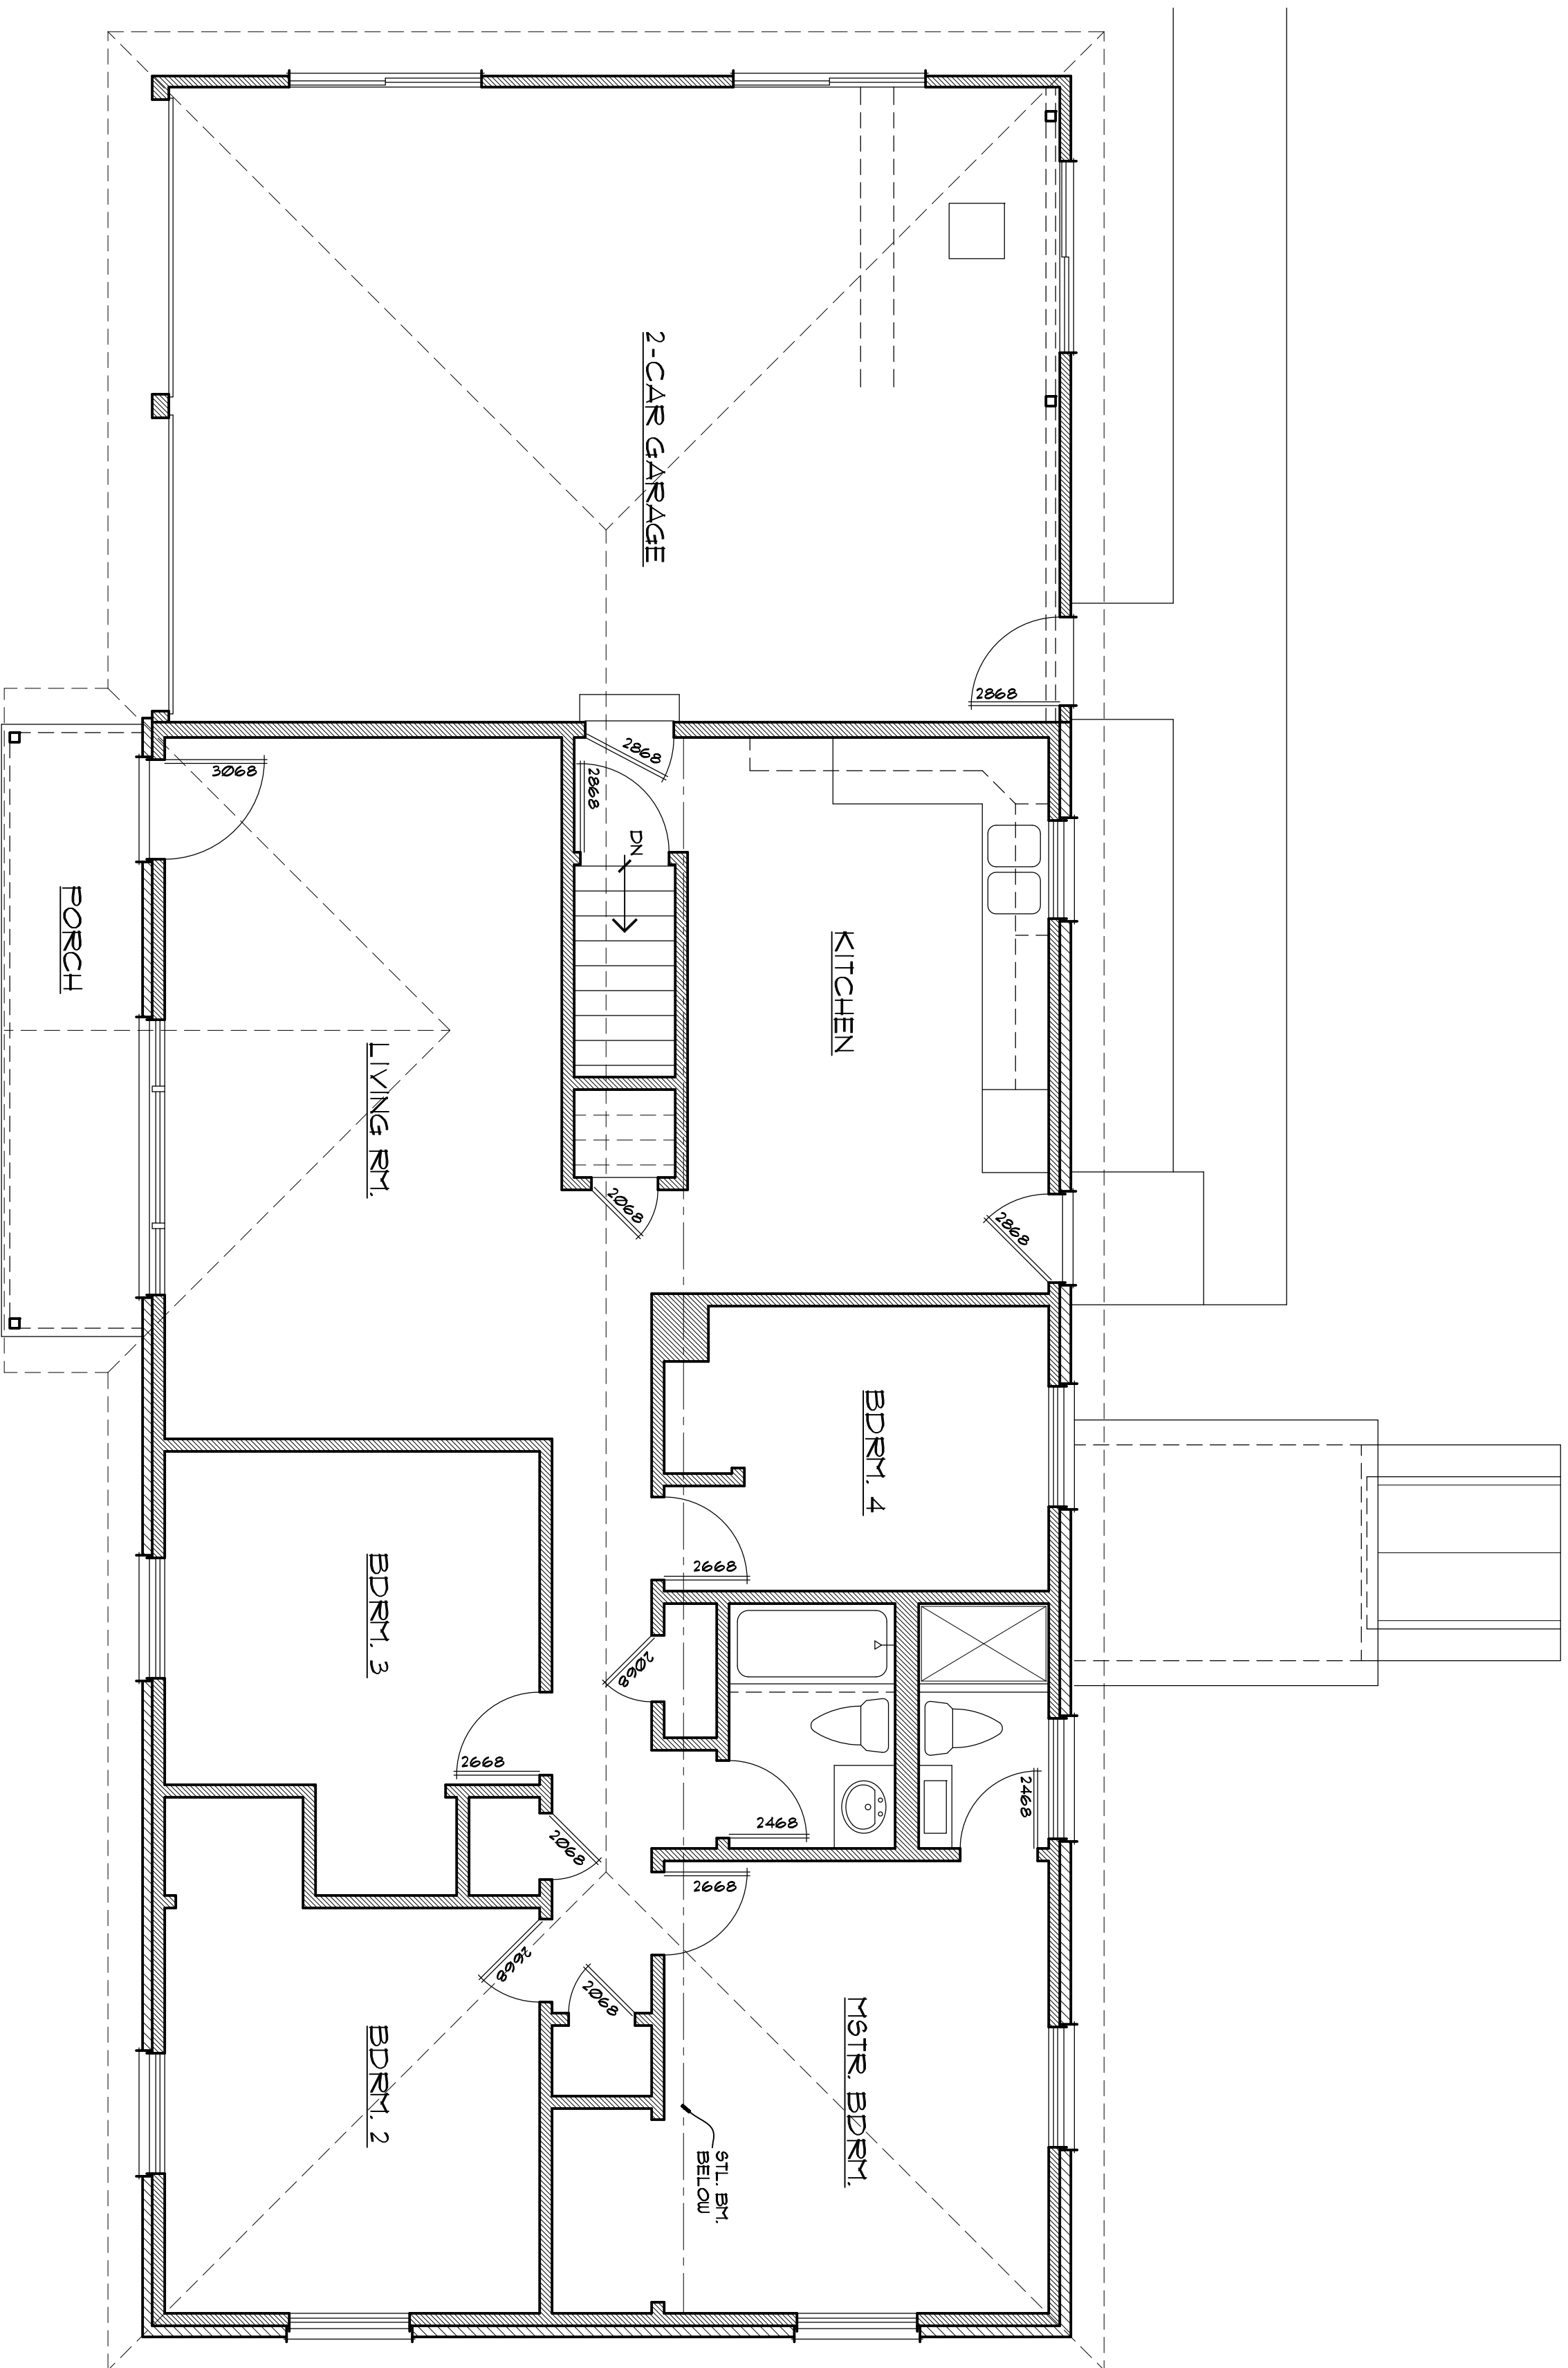

FIRST FLOOR PLAN
 1/4" = 1'-0"
 AS-BUILT