


REAR ELEVATION
1/4" = 1'-0"

RIGHT SIDE ELEVATION
1/4" = 1'-0"

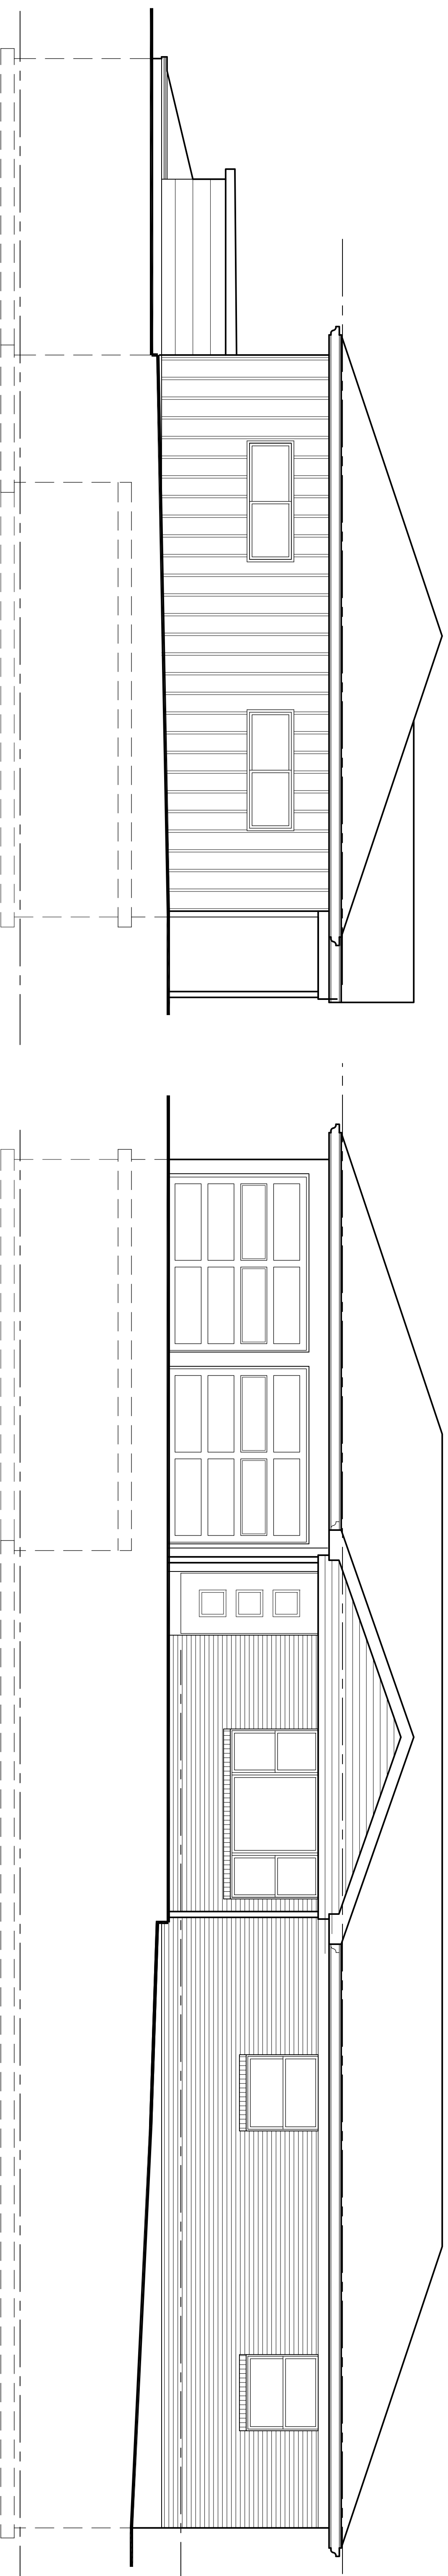

LEFT SIDE ELEVATION
1/4" = 1'-0"

FRONT ELEVATION
1/4" = 1'-0"

sheet:

2


of X

AS-BUILT ELEVATIONS

Office Remodel for:

Old State Investments
437 Old State Rd.
Ellisville, MO 63021

PRELIMINARY
NOT FOR
CONSTRUCTION


dick busch architects, p.c.
16618 old chesterfield rd.
chesterfield, mo 63017
(636) 530-1181
© copyright
dickbuscharchitects.com

date: 09/21/10
revised: